

COUNTY OF YAVAPAI
ARIZONA

AIRPORT IMPROVEMENTS
COTTONWOOD - CLEMENCEAU AIRPORT

1962

FAAP 9-02-004-6204
BOARD OF SUPERVISORS

JOHN J. PRUITT - CHAIRMAN
MARVIN E. ROHRER
ALVIN W. JASPERS - CLERK
R.L. MERRITT - COUNTY ENGINEER
TAYLOR E. ESTES

INDEX

- 1 - CONSTRUCTION LAYOUT PLAN
2 - RUNWAY PLAN & PROFILE
3 - ...
4 - ...
FAAP 9-02-004-6204

SUMMARY OF QUANTITIES

ITEM	DESCRIPTION	ESTIMATED	AS BUILT
PREPARE SUBGRADE	INCLUDES FINISHING & COMPACTING P-152	30,000 S.YDS	30,000 S.YDS
UNCLASSIFIED EXC.	" " " " COMPACTING P-152	4,243 C.YDS	9326 C.YDS
STABILIZER	INCLUDES FINISHING & COMPACTING P-208, TABLE 1 - STANDARD 8" C	5,926 C.YDS	5,926 C.YDS
MC-250	P-602 - 0.6 GAL / SQ. YD.	72.58 TONS	72.58 TONS
RS-2	P-604 - 0.3 GAL / SQ. YD.	37.5 TONS	37.35 TONS
CHIPS	P-604 1/4" MAX. 20 LBS. / SQ. YD.	300 TONS	300 TONS

AS BUILT

FAAP 9-02-004-6204

FEDERAL AVIATION AGENCY

APPROVED _____ CHIEF,
DATE _____ AIRPORTS DIVISION
APPROVED _____ DIST. AIRPORT ENGR
DATE _____

COUNTY OF YAVAPAI

APPROVED
DATE 3-28-62



JOHN J. PRUITT
CHAIRMAN

ATTEST
DATE 3-28-62

ALVIN W. JASPERS
CLERK

APPROVED
DATE 3-28-62

R.L. MERRITT
COUNTY ENGINEER

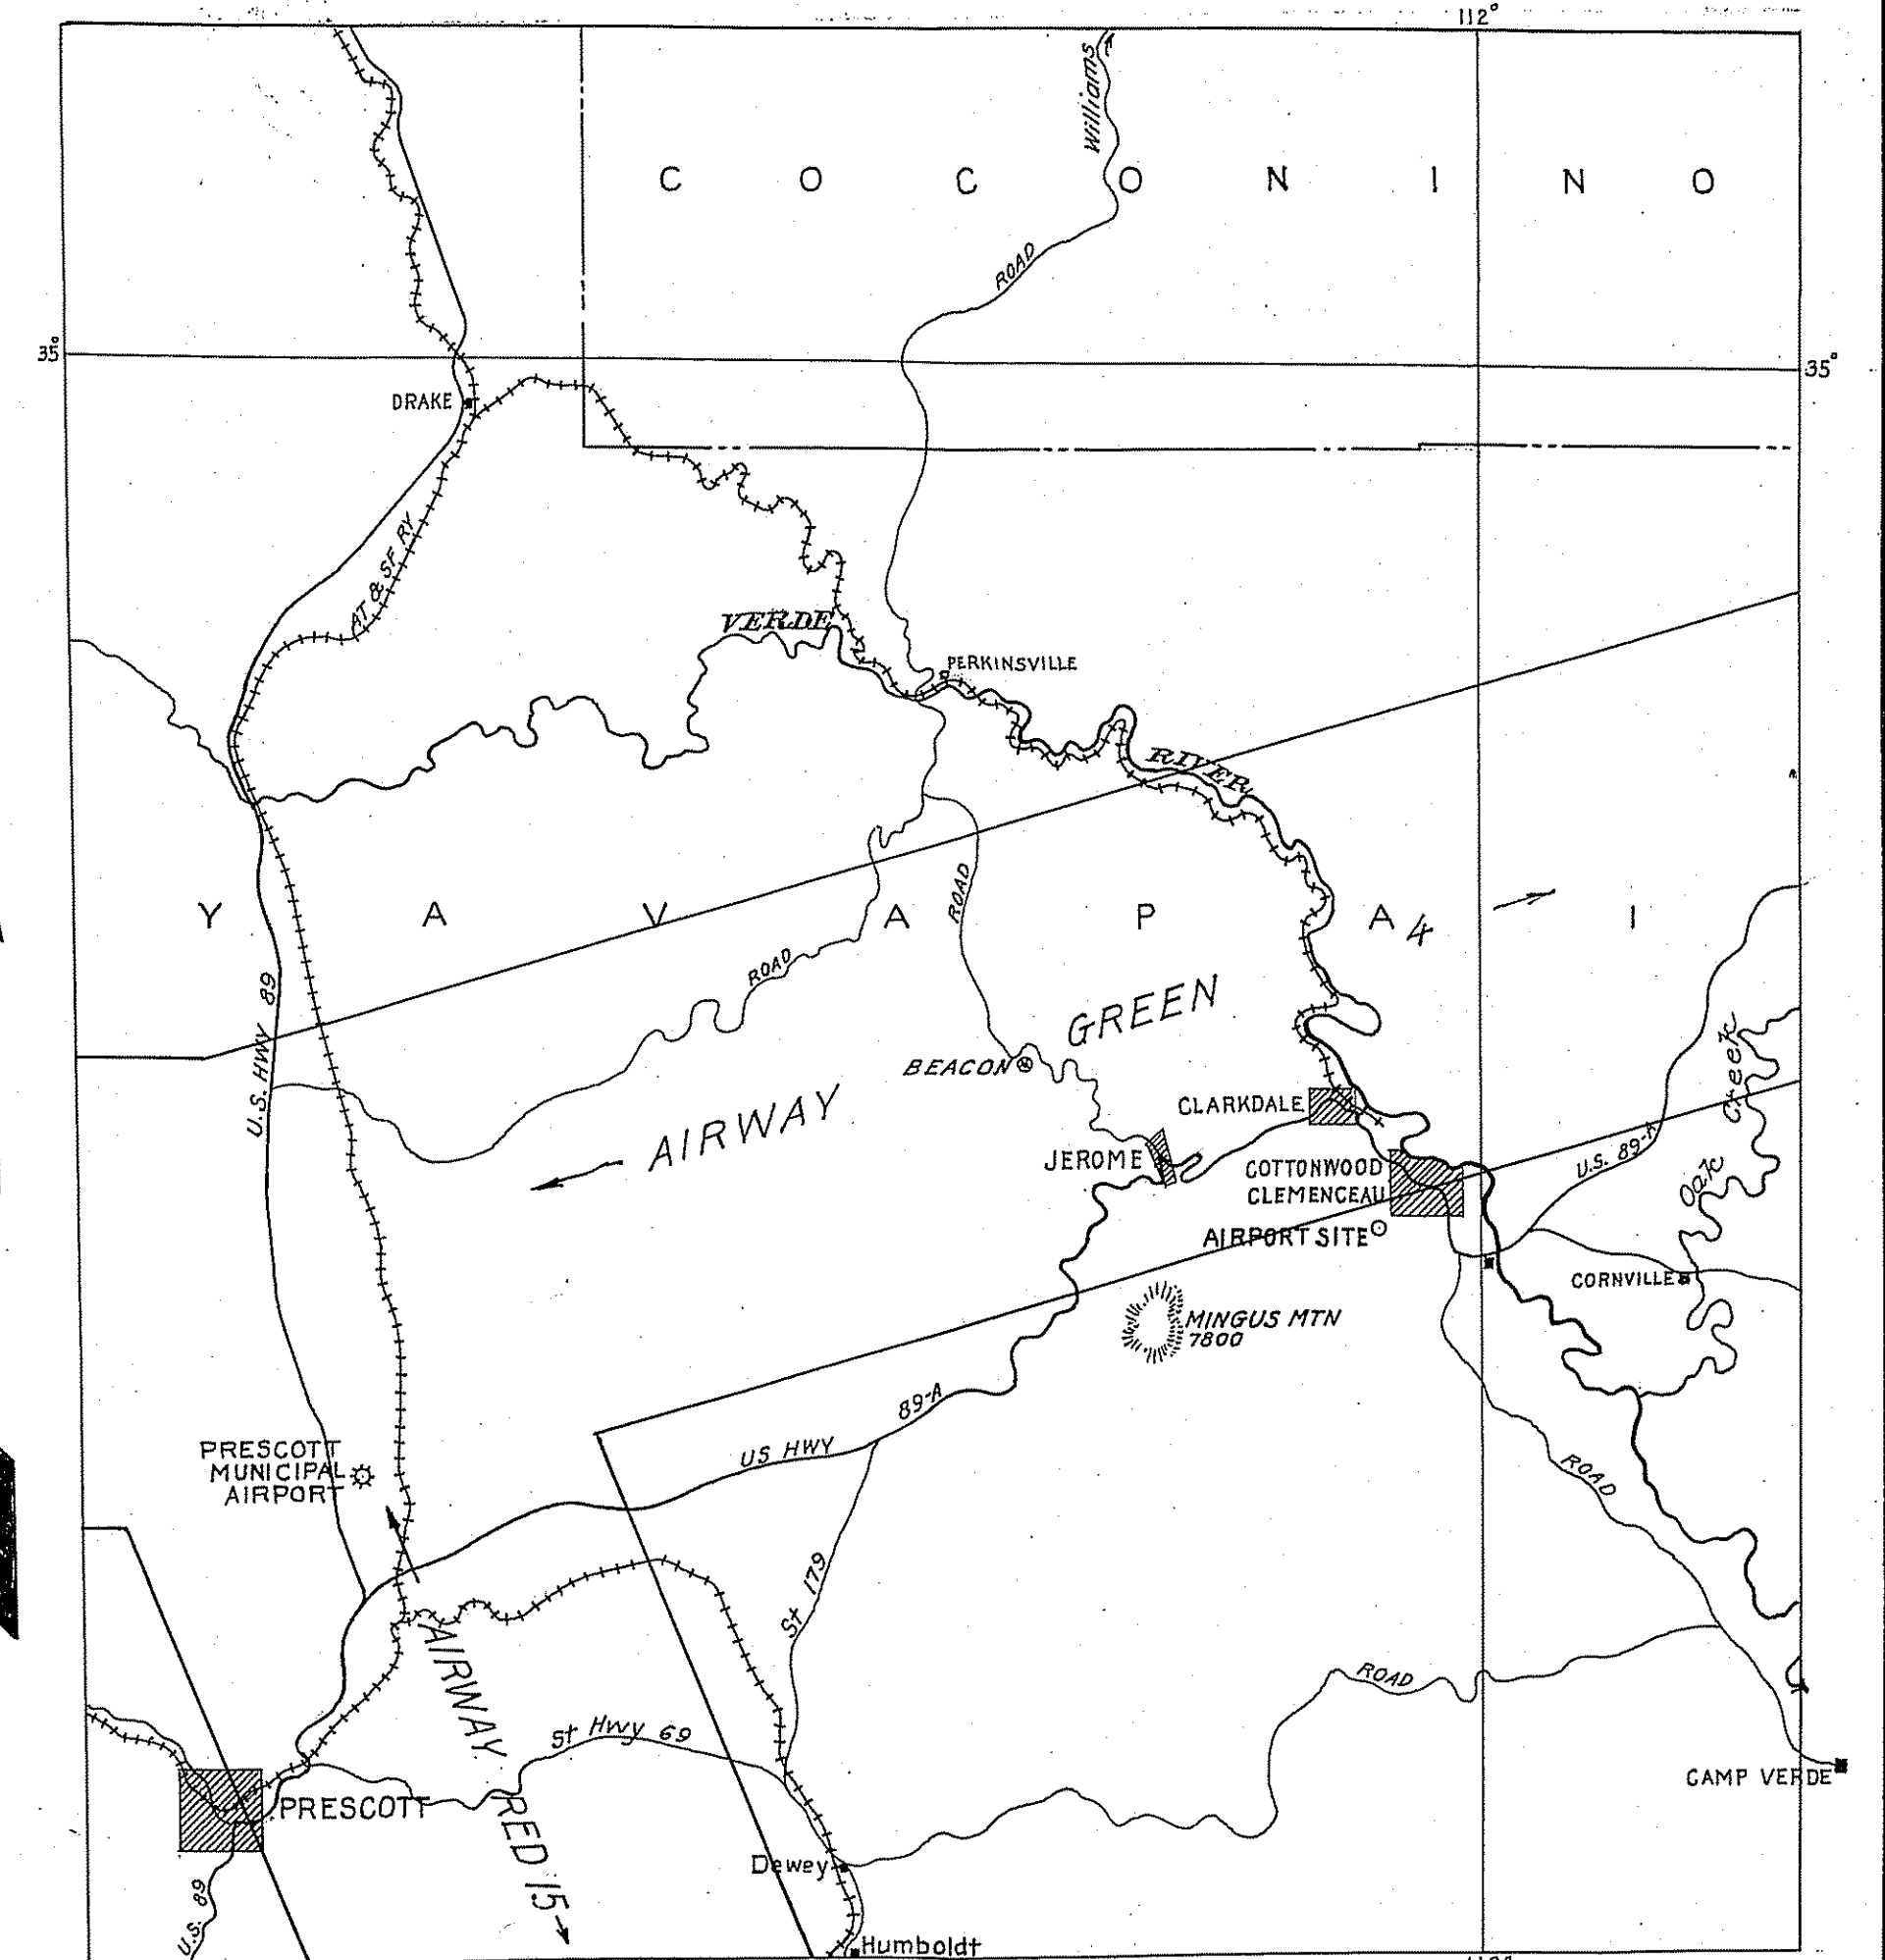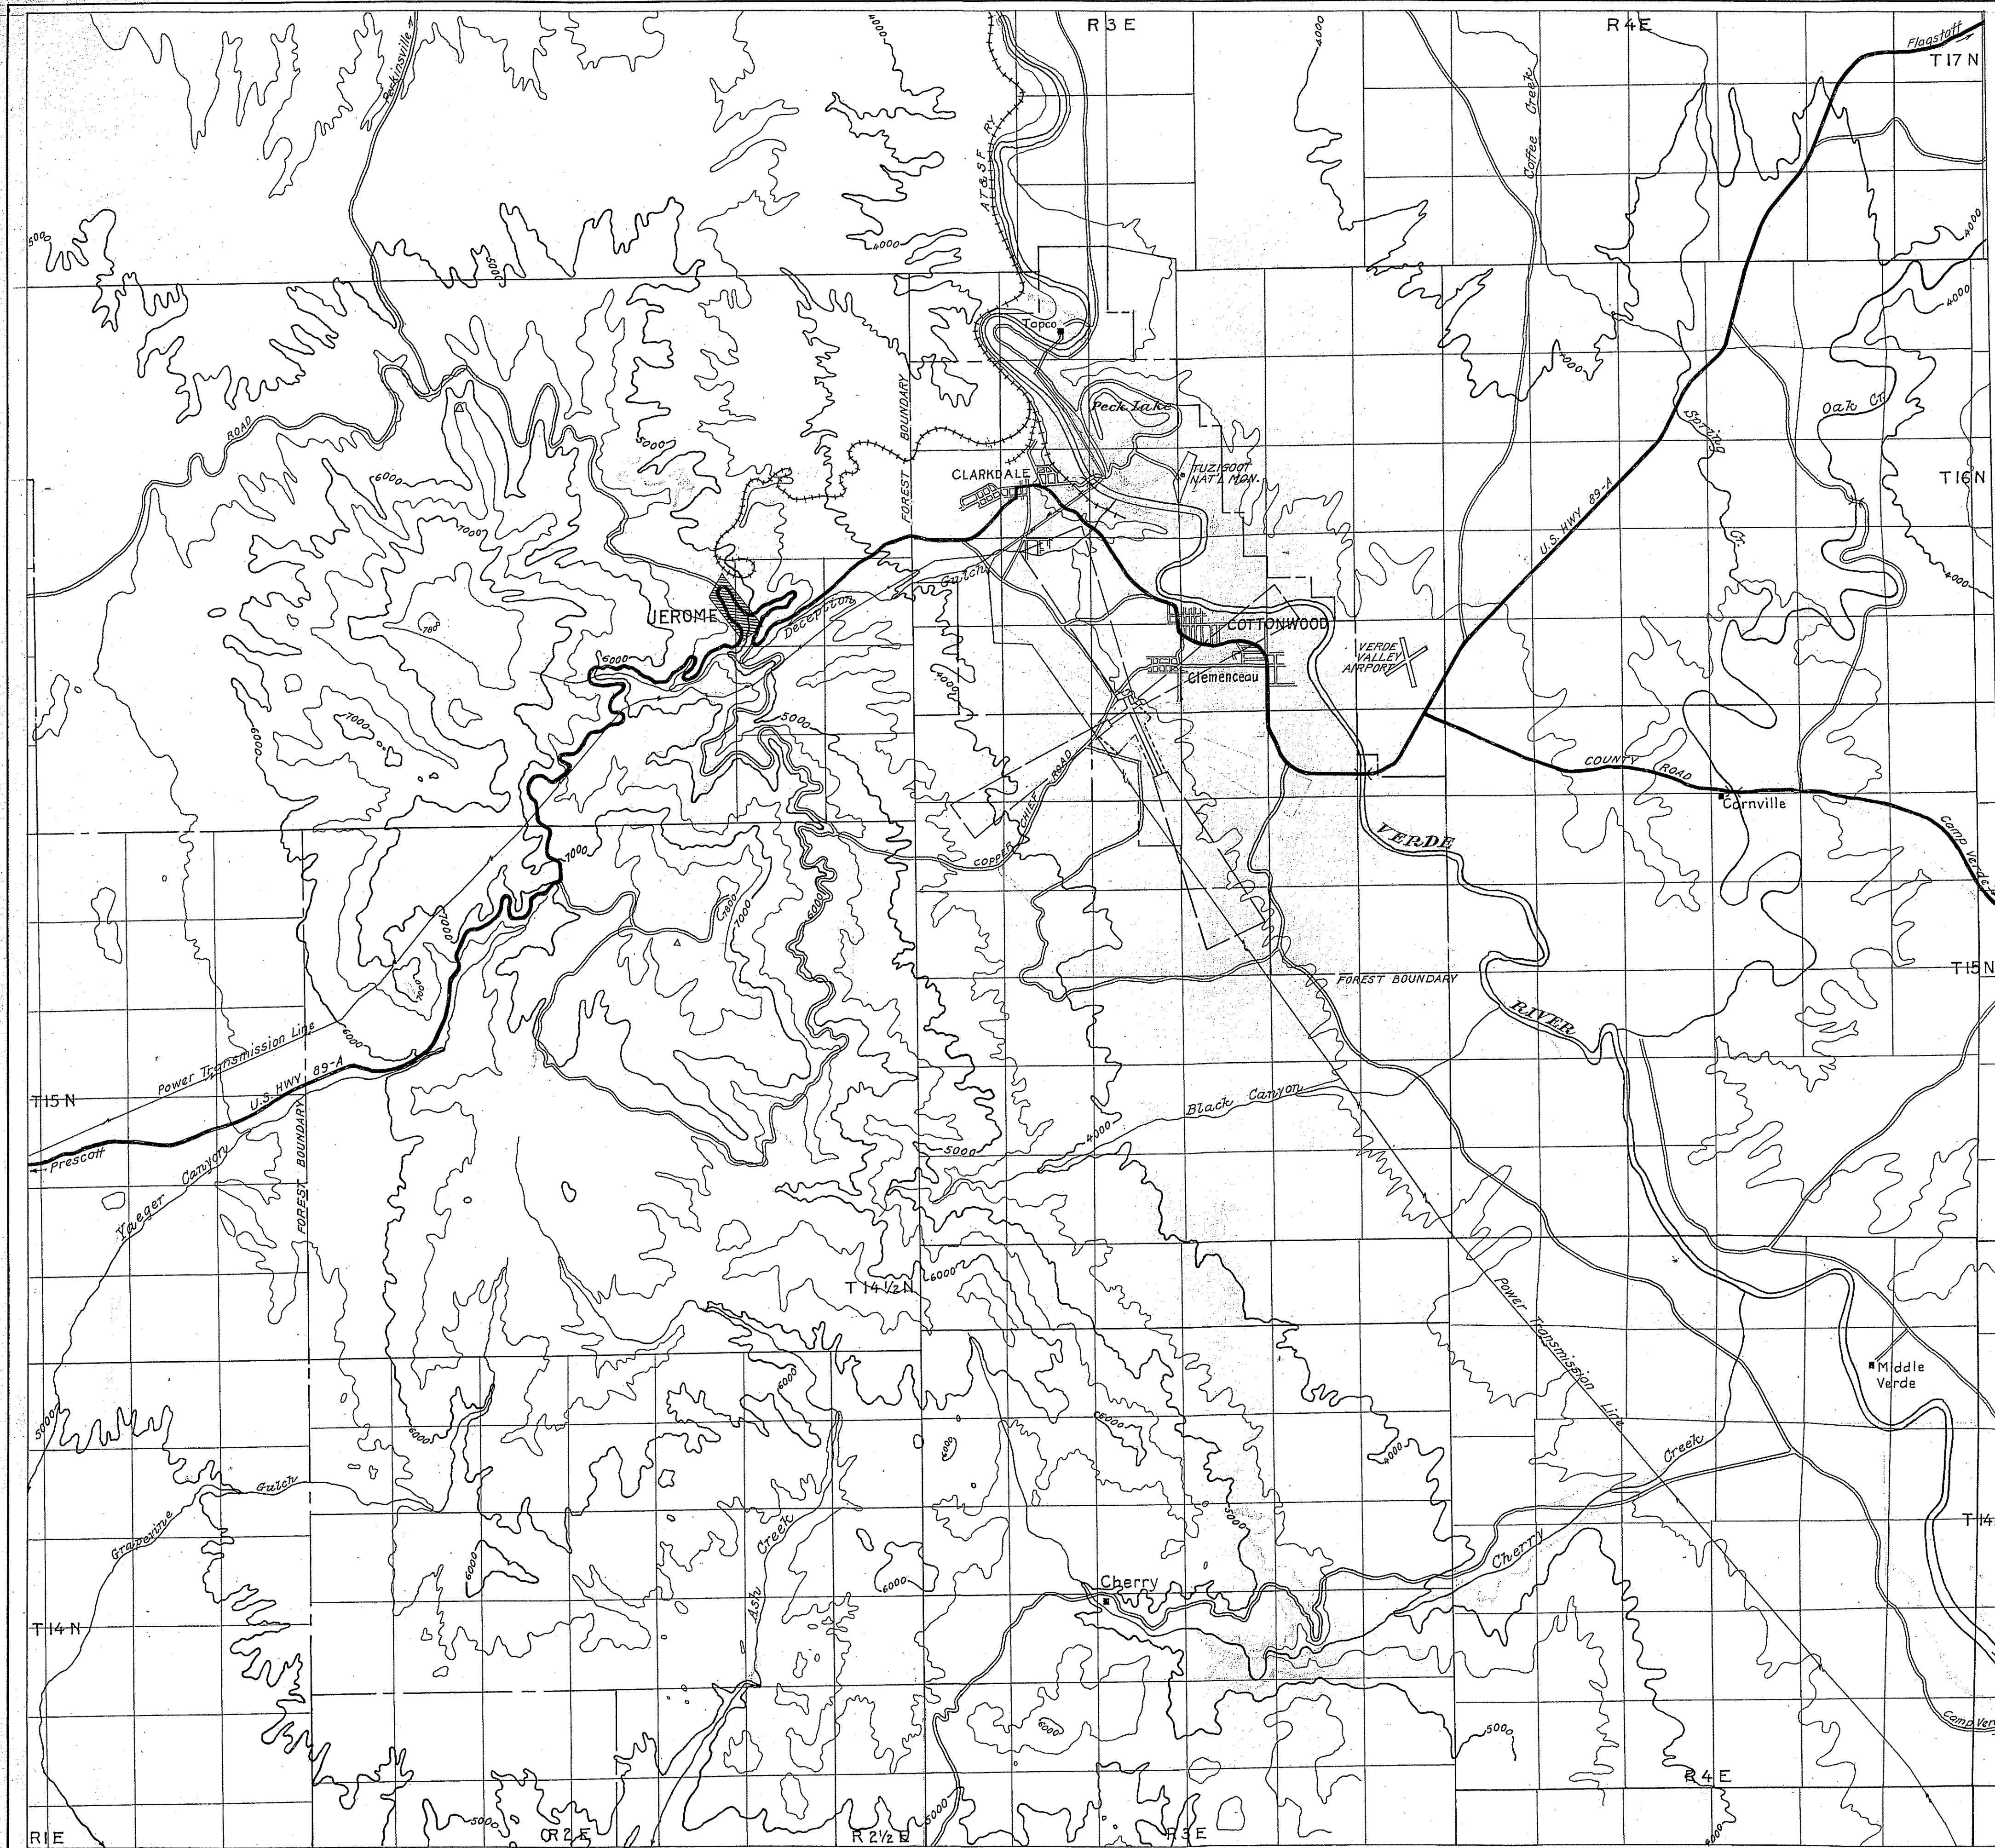

VICINITY MAP
Scale of Miles

FAAP 9-02-004-903

COTTONWOOD-CLEMENCEAU AIRPORT
YAVAPAI COUNTY-ARIZONA


LOCATION MAP

R.L. MERRITT, COUNTY ENGINEER
PRESCOTT, ARIZONA

Graphic Scale in Miles
Contour Interval 500 Feet

JANUARY, 1950

SHEET 2 OF 11 SHEETS

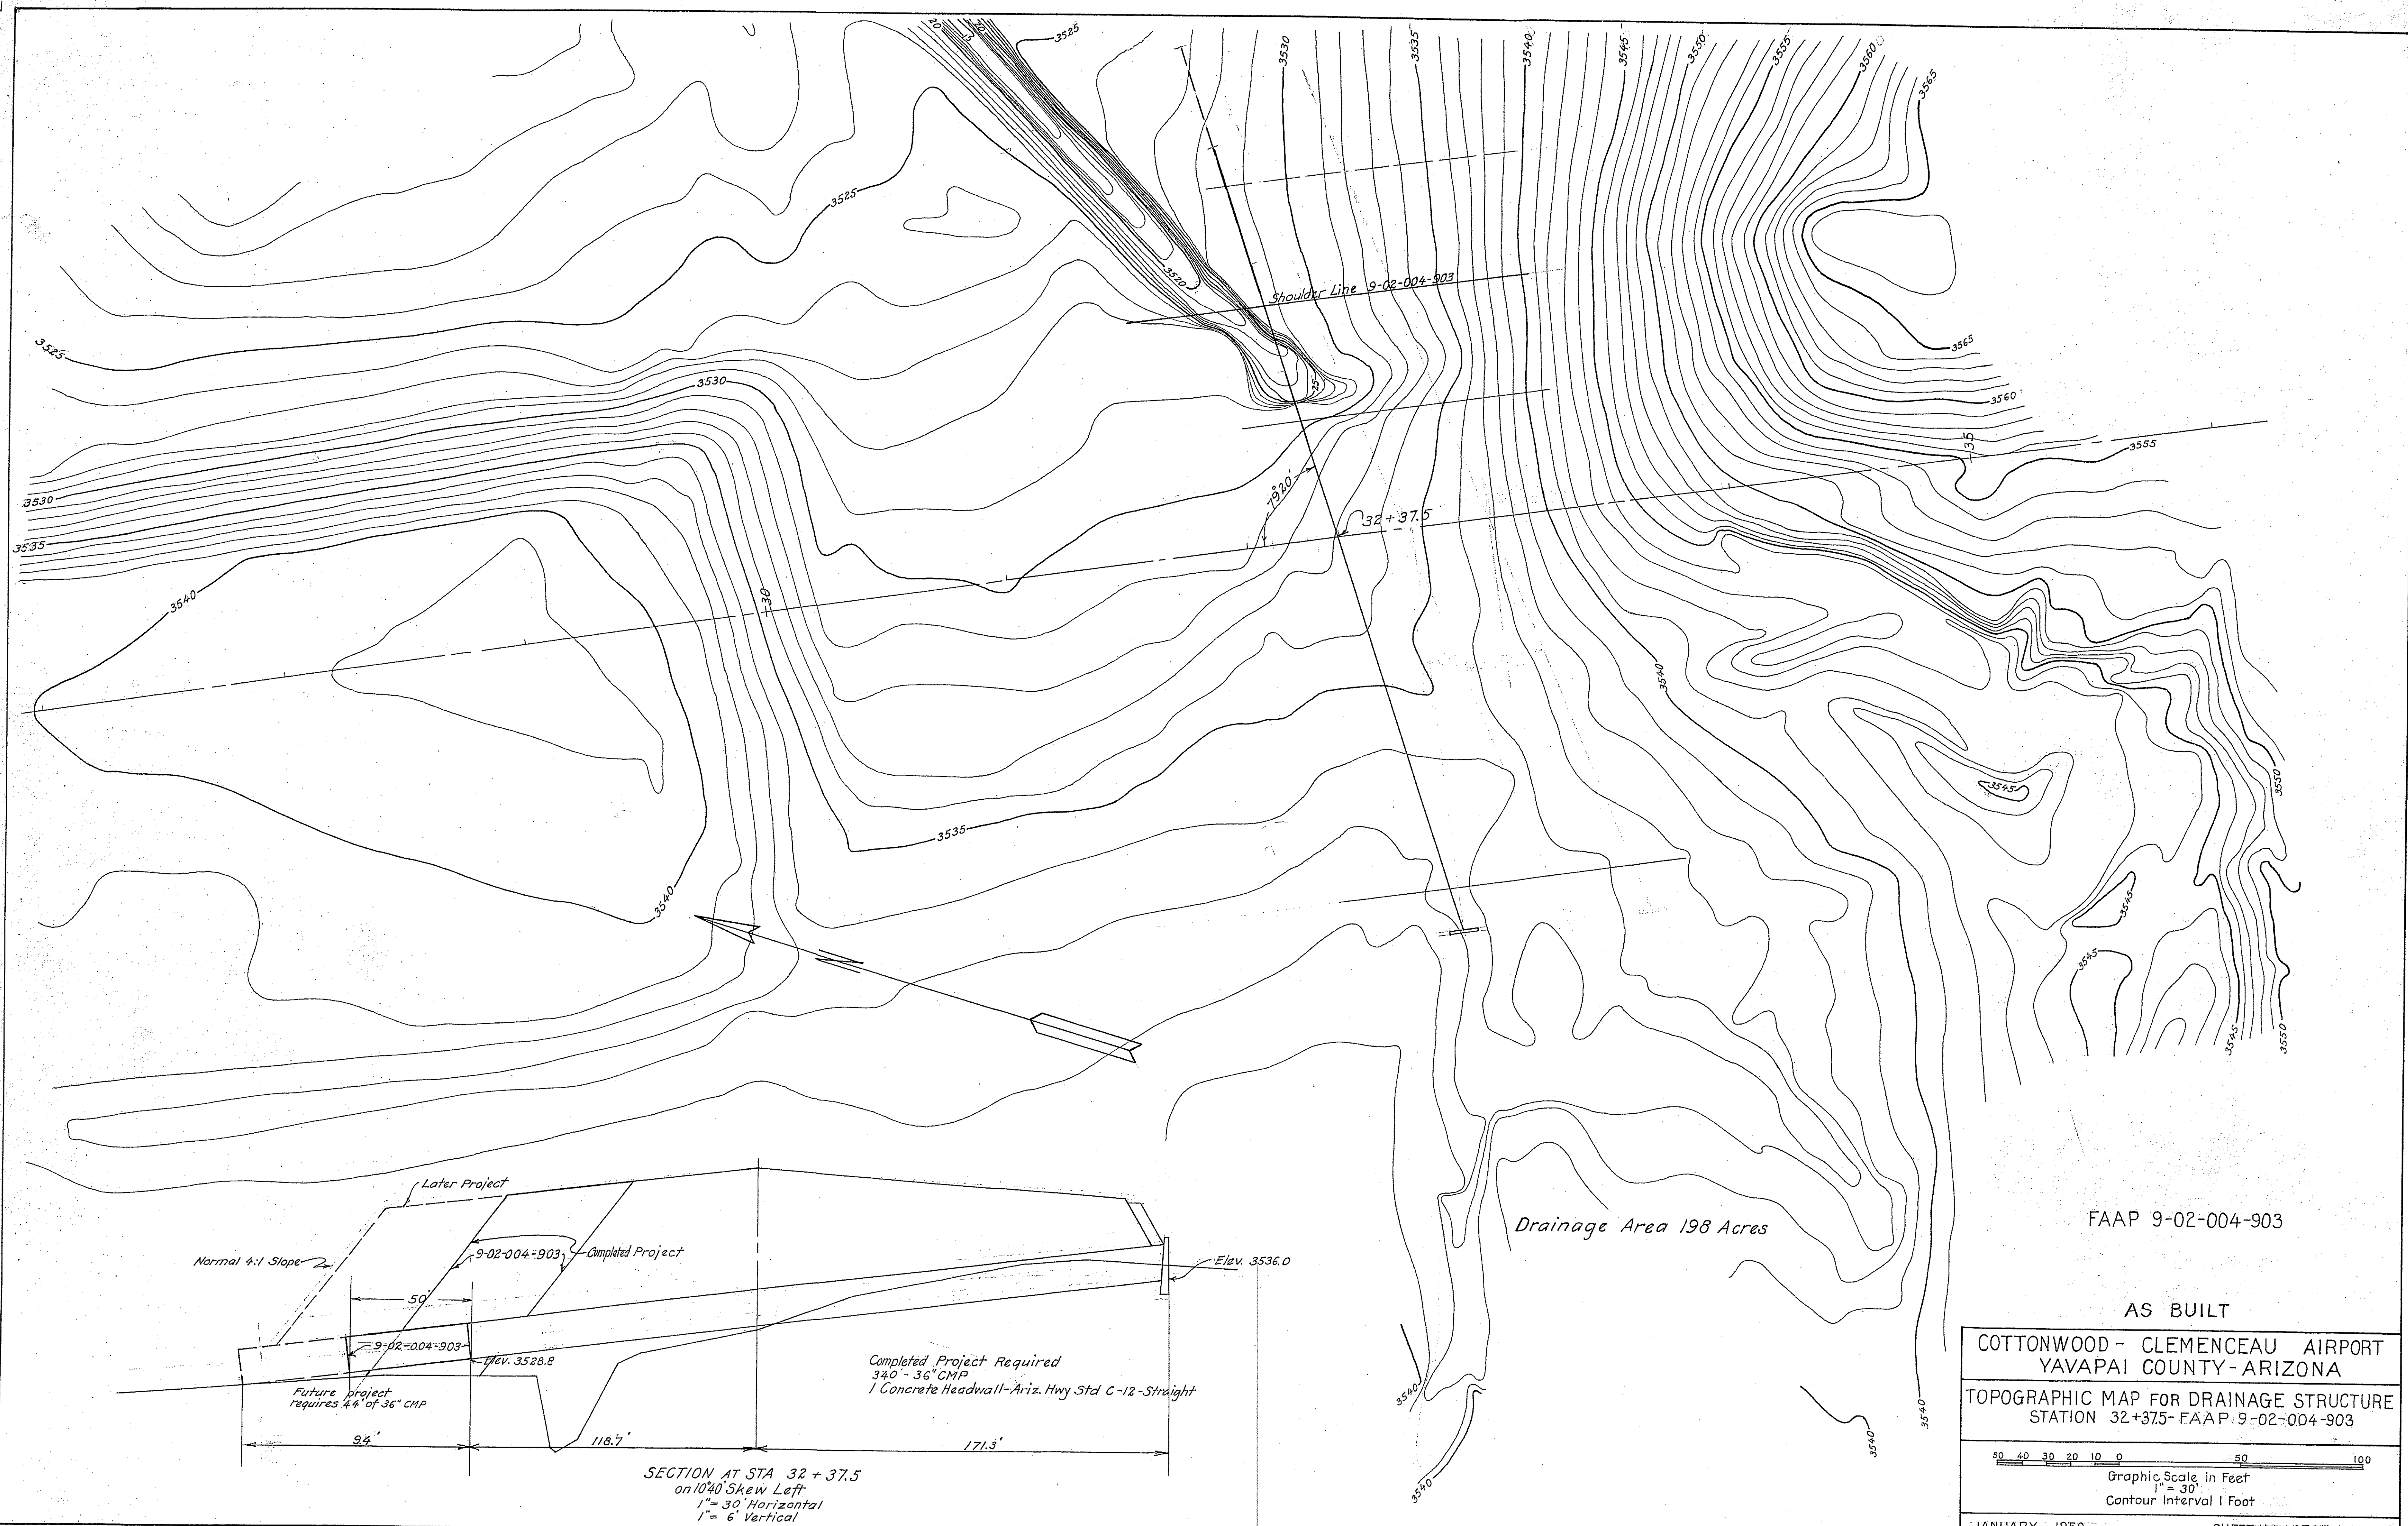

FAAP 9-02-004-903

AS BUILT

COTTONWOOD - CLEMENCEAU AIRPORT
YAVAPAI COUNTY-ARIZONA

TOPOGRAPHIC MAP FOR DRAINAGE STRUCTURE
STATION 32+37.5-FAAP 9-02-004-903

50 40 30 20 10 0 50 100
Graphic Scale in Feet
1" = 30'
Contour Interval 1 Foot

JANUARY 1950 SHEET 11 OF 11 SHEETS